



**P&ID UNIT 14 HERU4- LIQUEFACTION UNIT LIQUEFIER
COLD BOX FIRST AND SECOND EXCHANGERS**

Duplicate from 68-14-PR-PID-01020

AS BUILT

RETURN TO VENDOR		RESPOND BY
☐	A – REVIEWED WITH NO COMMENT	
☐	B – REVIEWED WITH COMMENTS AS NOTED	
☐	C – DO NOT PROCEED WITH FABRICATION	
☐	D – RECEIVED AS INFORMATION	
DATE:		


51	AS BUILT	C. URBAN	C. URBAN	G. PICCARRETA	21/05/2025
50	AS BUILT	M. ORLOV	M. ORLOV	G. PICCARRETA	14/01/2025
REV	DESCRIPTION	BY	CHKD	APVD	DATE

REVISIONS

CLIENT	:	Qatargas Operating Company Limited	CONTRACT No. : LTC/C/NFE/3945/18
PROJECT	:	North Field East Project Onshore LNG Facilities	
DOC CLASS	:	1	
DOC NO.	:	3945_18-ME20829A-00056	

Operation Center Document No.:

53125-69-01-PR-014093

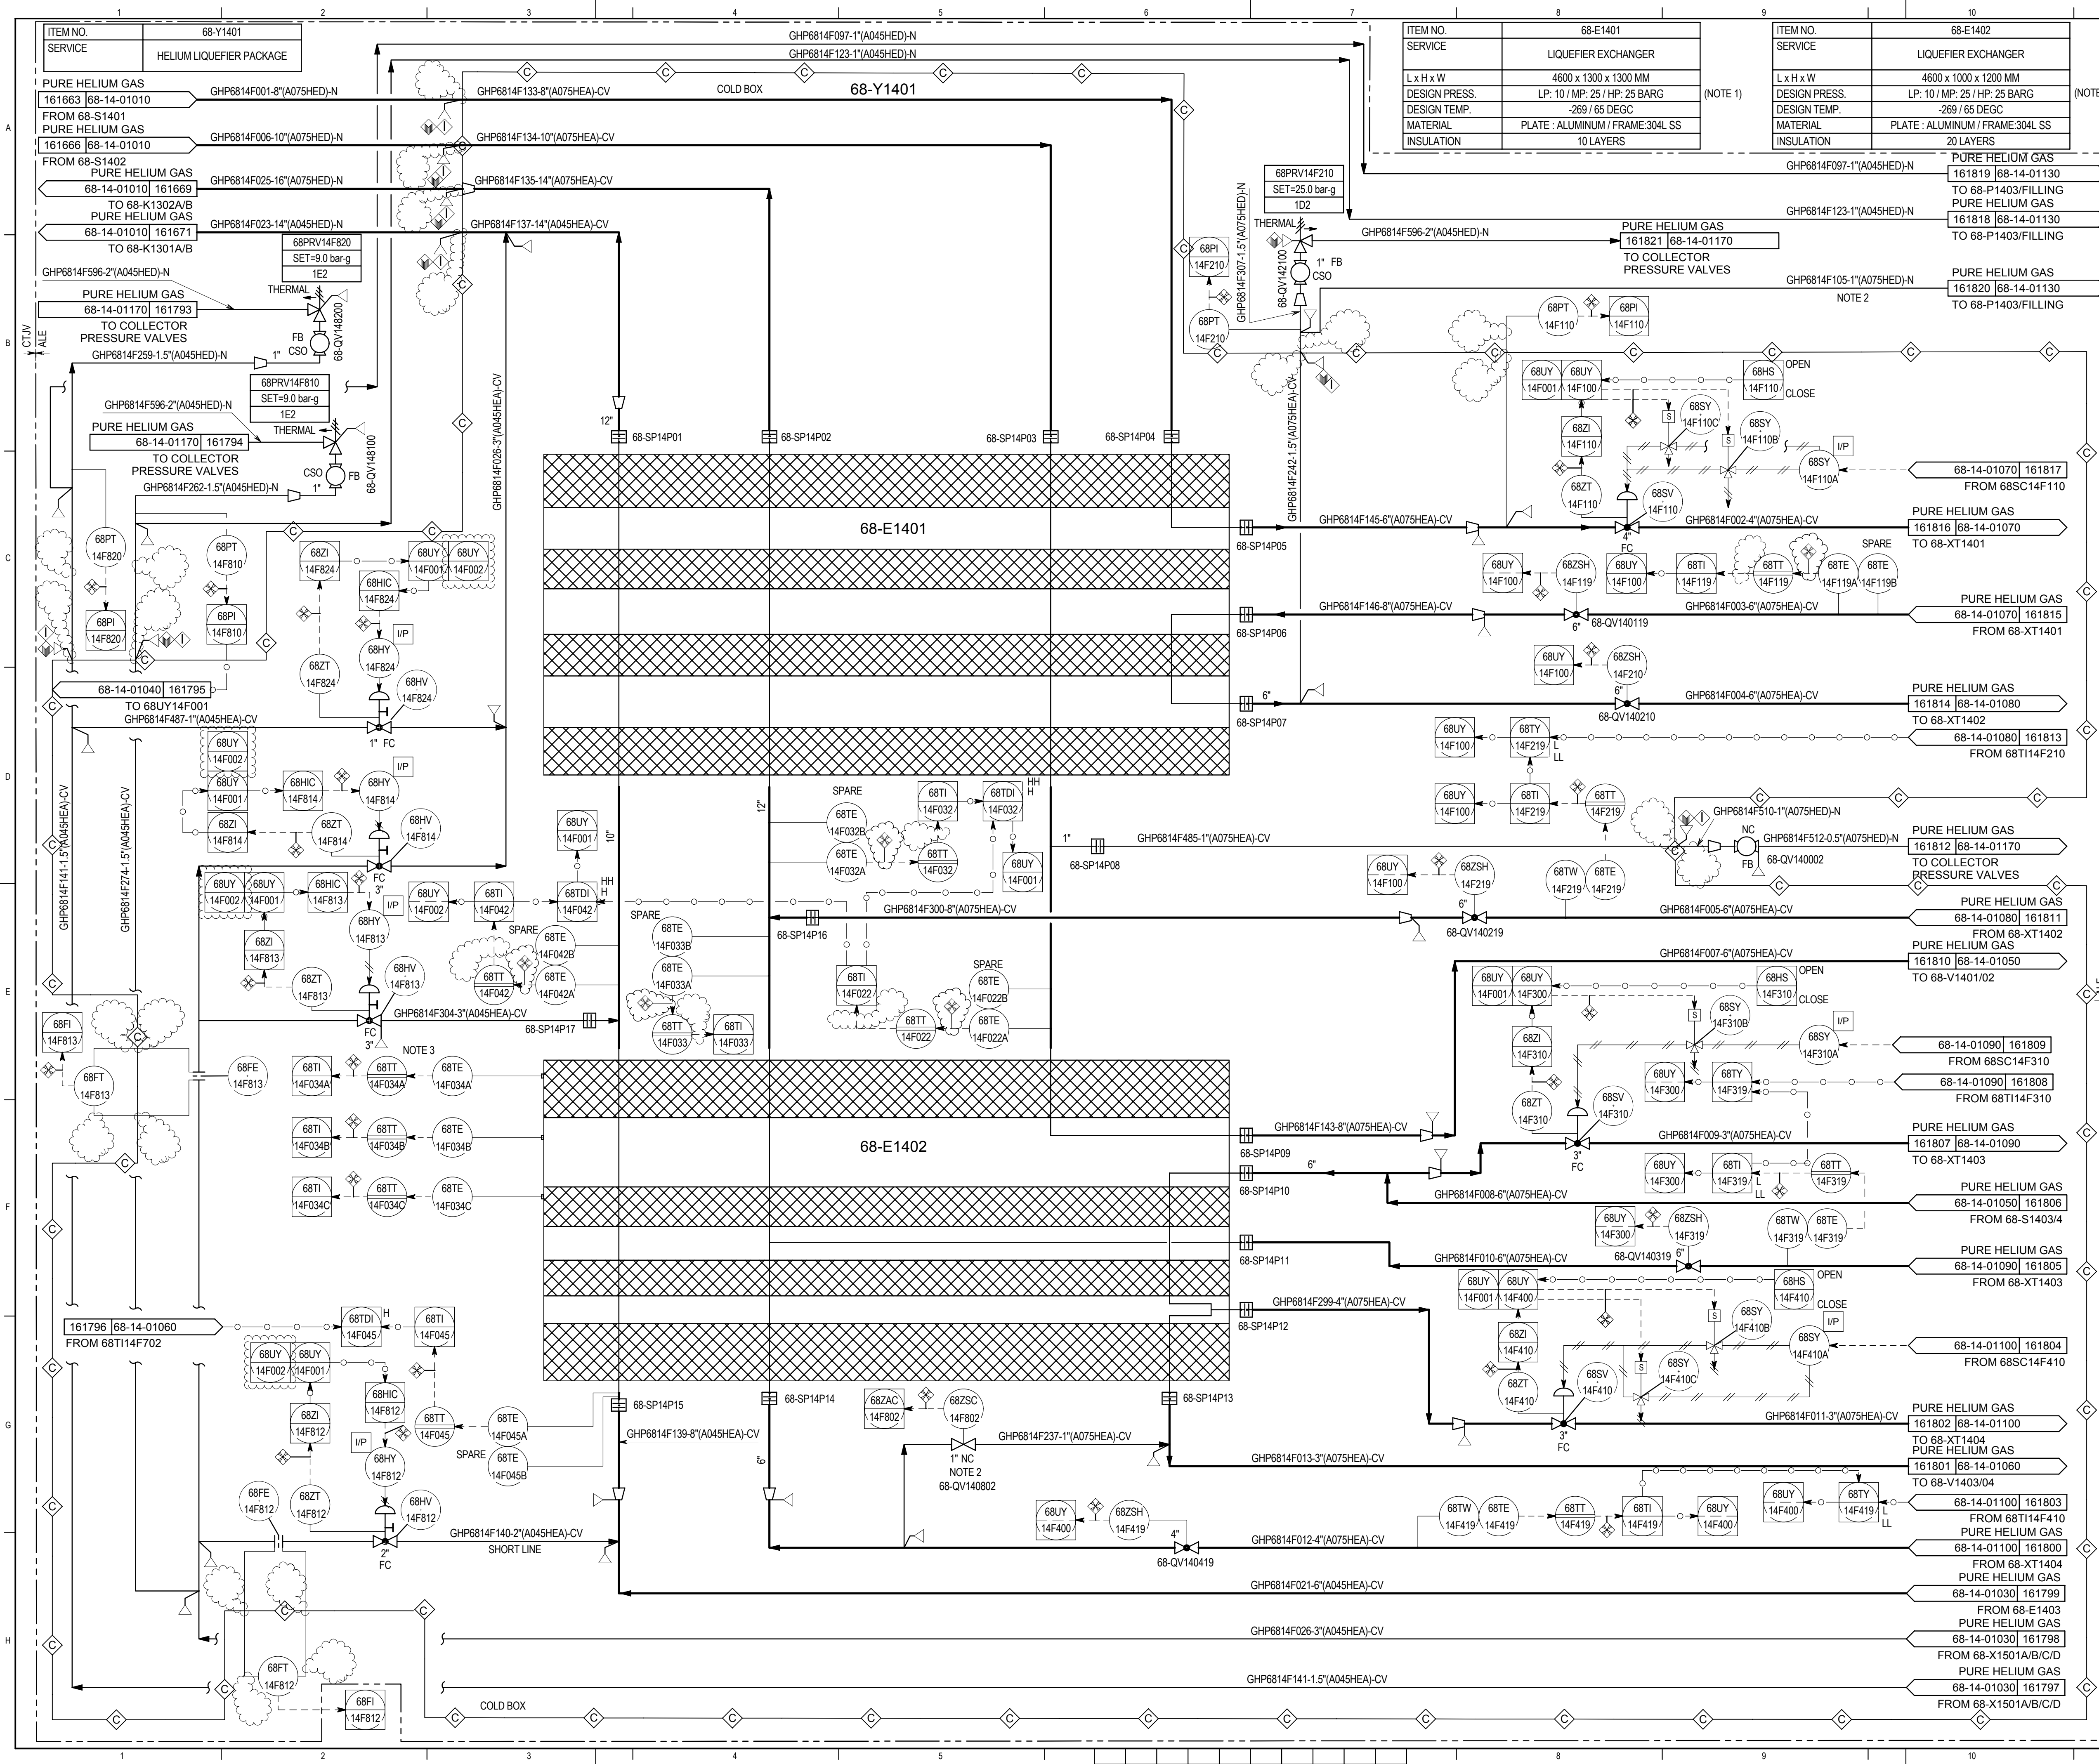

- GENERAL NOTES:
- FOR GENERAL NOTES, ABBREVIATIONS, SYMBOLS AND TYPICALS SEE DWGS 60-00-PR-PID-00001 THRU 60-00-PR-PID-00224.
 - ALL TRANSMITTER ARE PHYSICALLY INSTALLED OUTSIDE THE COLD BOX.
 - VENDOR PIPING CLASSES AS PER DOCUMENT REF. 3945_18-ME20829A-00641.
 - THE ON/OFF VALVES ARE SPECIFIC DESIGN TO ALE OF WHICH COMPLETE REPRESENTATION IS SHOWN IN P&ID. THE TYPICAL ON/OFF VALVE REPRESENTATION PROVIDED IN P&ID LEAD SHEET IS NOT APPLICABLE HERE.

- NOTES:
- MECHANICAL RESISTANCE CALCULATION TO BE CARRIED OUT AT DESIGN PRESSURE +1 BAR TO TAKE INTO ACCOUNT THE VACUUM ON THE OTHER SIDE OF THE VESSEL WALL.
 - FOR DERIVING.
 - A : TOP
B : INTERMEDIATE
C : BOTTOM

- GENERAL HOLDS:
- DELETED.
 - DELETED.
- HOLDS:
- DELETED.

INTERLOCK LIST:

- LOGIC LIST:
- 68UY14F001 : LIQUEFIER LOGIC.
 - 68UY14F002 : VAPOR RETURN LOGIC.
 - 68UY14F100 : FIRST AND SECOND TURBINE LOGIC.
 - 68UY14F300 : THIRD TURBINE LOGIC.
 - 68UY14F400 : FOURTH TURBINE LOGIC.

AS BUILT

DWG NO.		TITLE			
		REFERENCE DRAWINGS			
3	APPROVED FOR CONSTRUCTION (AFC2)	PGU	SMS	OMA	30AUG24
2	APPROVED FOR CONSTRUCTION (AFC1)	SMS	YRE	OMA	11MAR24
1	APPROVED FOR DESIGN (AFD2)	EDU	YRE	OMA	20SEP23
0	APPROVED FOR DESIGN (AFD)	EDU	ORO	ALO	15DEC22
B	ISSUED FOR APPROVAL (IFA)	CSO	AVA	ALO	17JAN22

REVISIONS					
DATE	DRN	DSGND	CHKD	APVD	APVD
17JAN22	AHO	CSO	AVA	ALO	ALO

PROJECT TITLE: **North Field East Project Onshore LNG Facilities**

QatarGas Operating Company Ltd.

THIS DOCUMENT IS PROPERTY OF QATAR GAS. THIS DRAWING OR MATERIAL DESCRIBED THEREIN MAY NOT BE COPIED OR DISCLOSED IN ANY FORM OR MEDIUM TO THIRD PARTIES, OR USED FOR OTHER THAN THE PURPOSE FOR WHICH IT HAS BEEN PROVIDED, IN WHOLE OR IN PART IN ANY MANNER EXCEPT AS EXPRESSLY PERMITTED BY QATAR GAS.

CONSULTANT / CONTRACTOR: **CTV**

TITLE: **PIPING & INSTRUMENT DIAGRAM**
UNIT 14 HERU4 - LIQUEFACTION UNIT
LIQUEFIER COLD BOX FIRST & SECOND EXCHANGERS

SCALE:		PROJECT NO. : LTCOMFE3945/18			
PROJECT	DRAWING NO.	SHT	SIZE	REVISION	
NFE1	3945_18-ME20829A-00056	-	A1	3	

Op. Center Doc No. 202048C-6814-PID-0021-1020 AFC2