



UPGRADER COLD BOX - GENERAL SHEETING OPENING DRAWING

AS BUILT

RETURN TO VENDOR		RESPOND BY
✓	A – REVIEWED WITH NO COMMENT	
	B – REVIEWED WITH COMMENTS AS NOTED	
	C – DO NOT PROCEED WITH FABRICATION	
	D – RECEIVED AS INFORMATION	
DATE:		

50	AS BUILT (ASB)	RH	JM	JM	22/05/2024
2	APPROVED FOR CONSTRUCTION (AFC)	RH	JM	TB	5/23/2023
1	APPROVED FOR CONSTRUCTION (AFC)	RH	JM	MH	3/31/2023
0	ISSUED FOR INFORMATION (IFI)	RH	JM	MH	1/18/2023
REV	DESCRIPTION	BY	CHKD	APVD	DATE

REVISIONS


CLIENT	:	Qatargas Operating Company Limited	CONTRACT No. : LTC/C/NFE/3945/18
PROJECT	:	North Field East Project Onshore LNG Facilities	
DOC CLASS	:	3	
DOC NO.	:	3945_18-ME20829A-00762	

VIEW A
LOOKING NORTH

VIEW B
LOOKING EAST


VIEW C
LOOKING SOUTH

VIEW D
LOOKING WEST

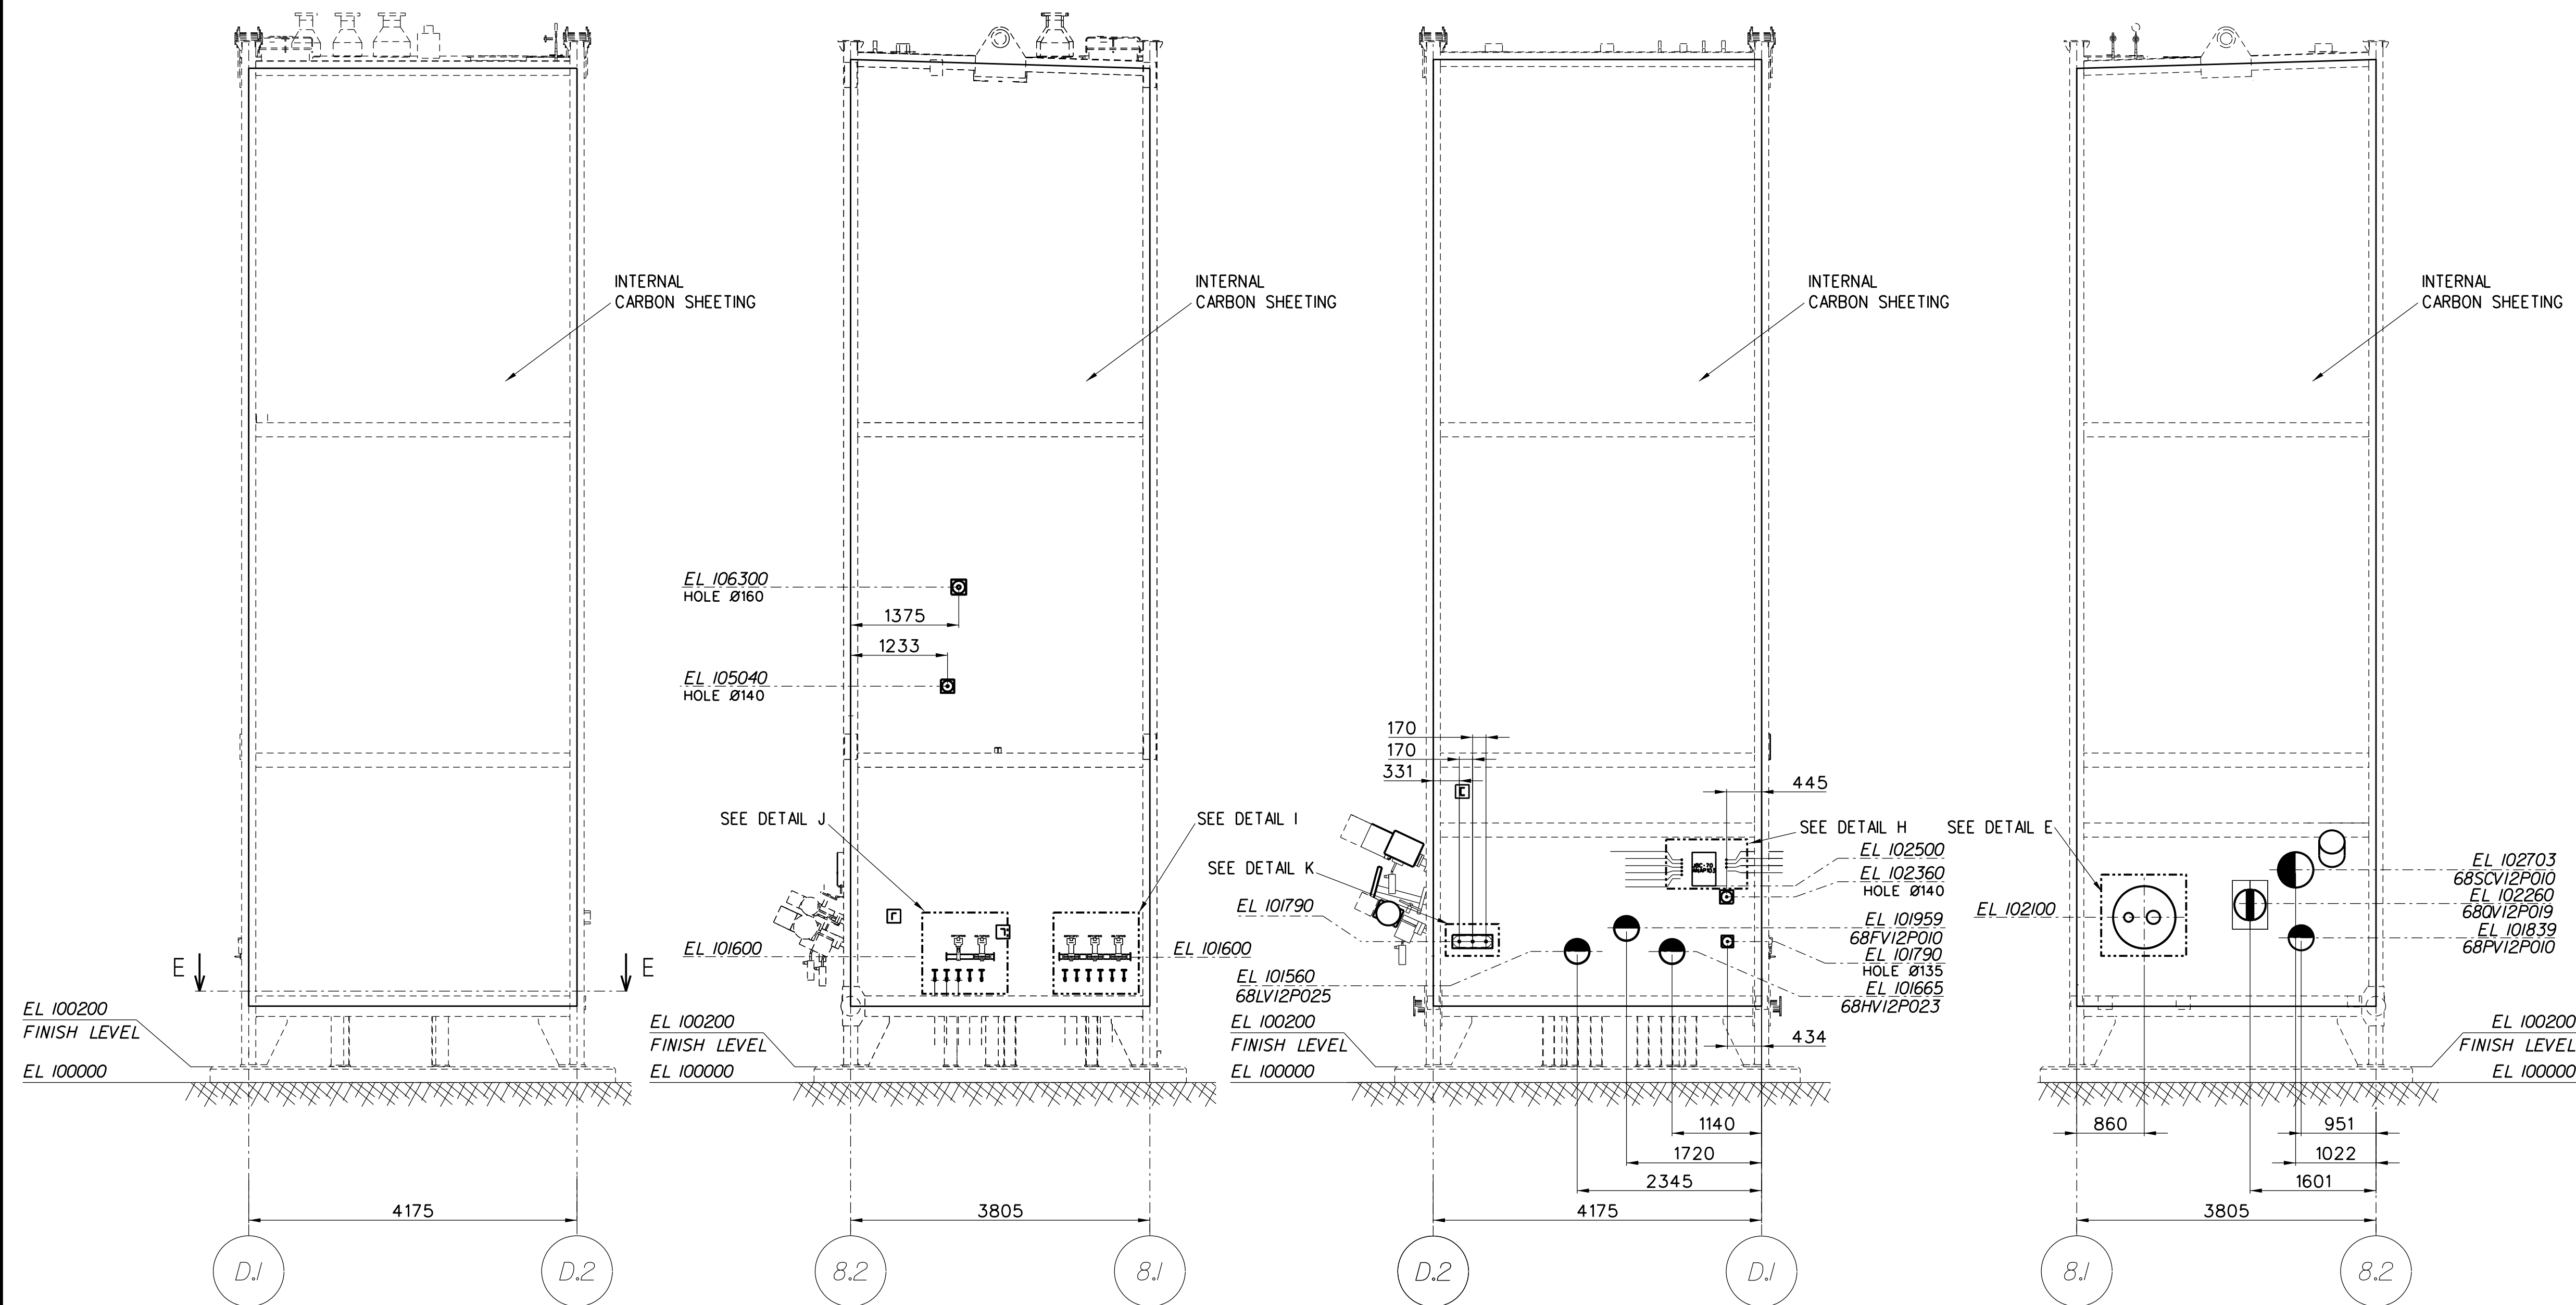

ROOF VIEW

SECTION E-E

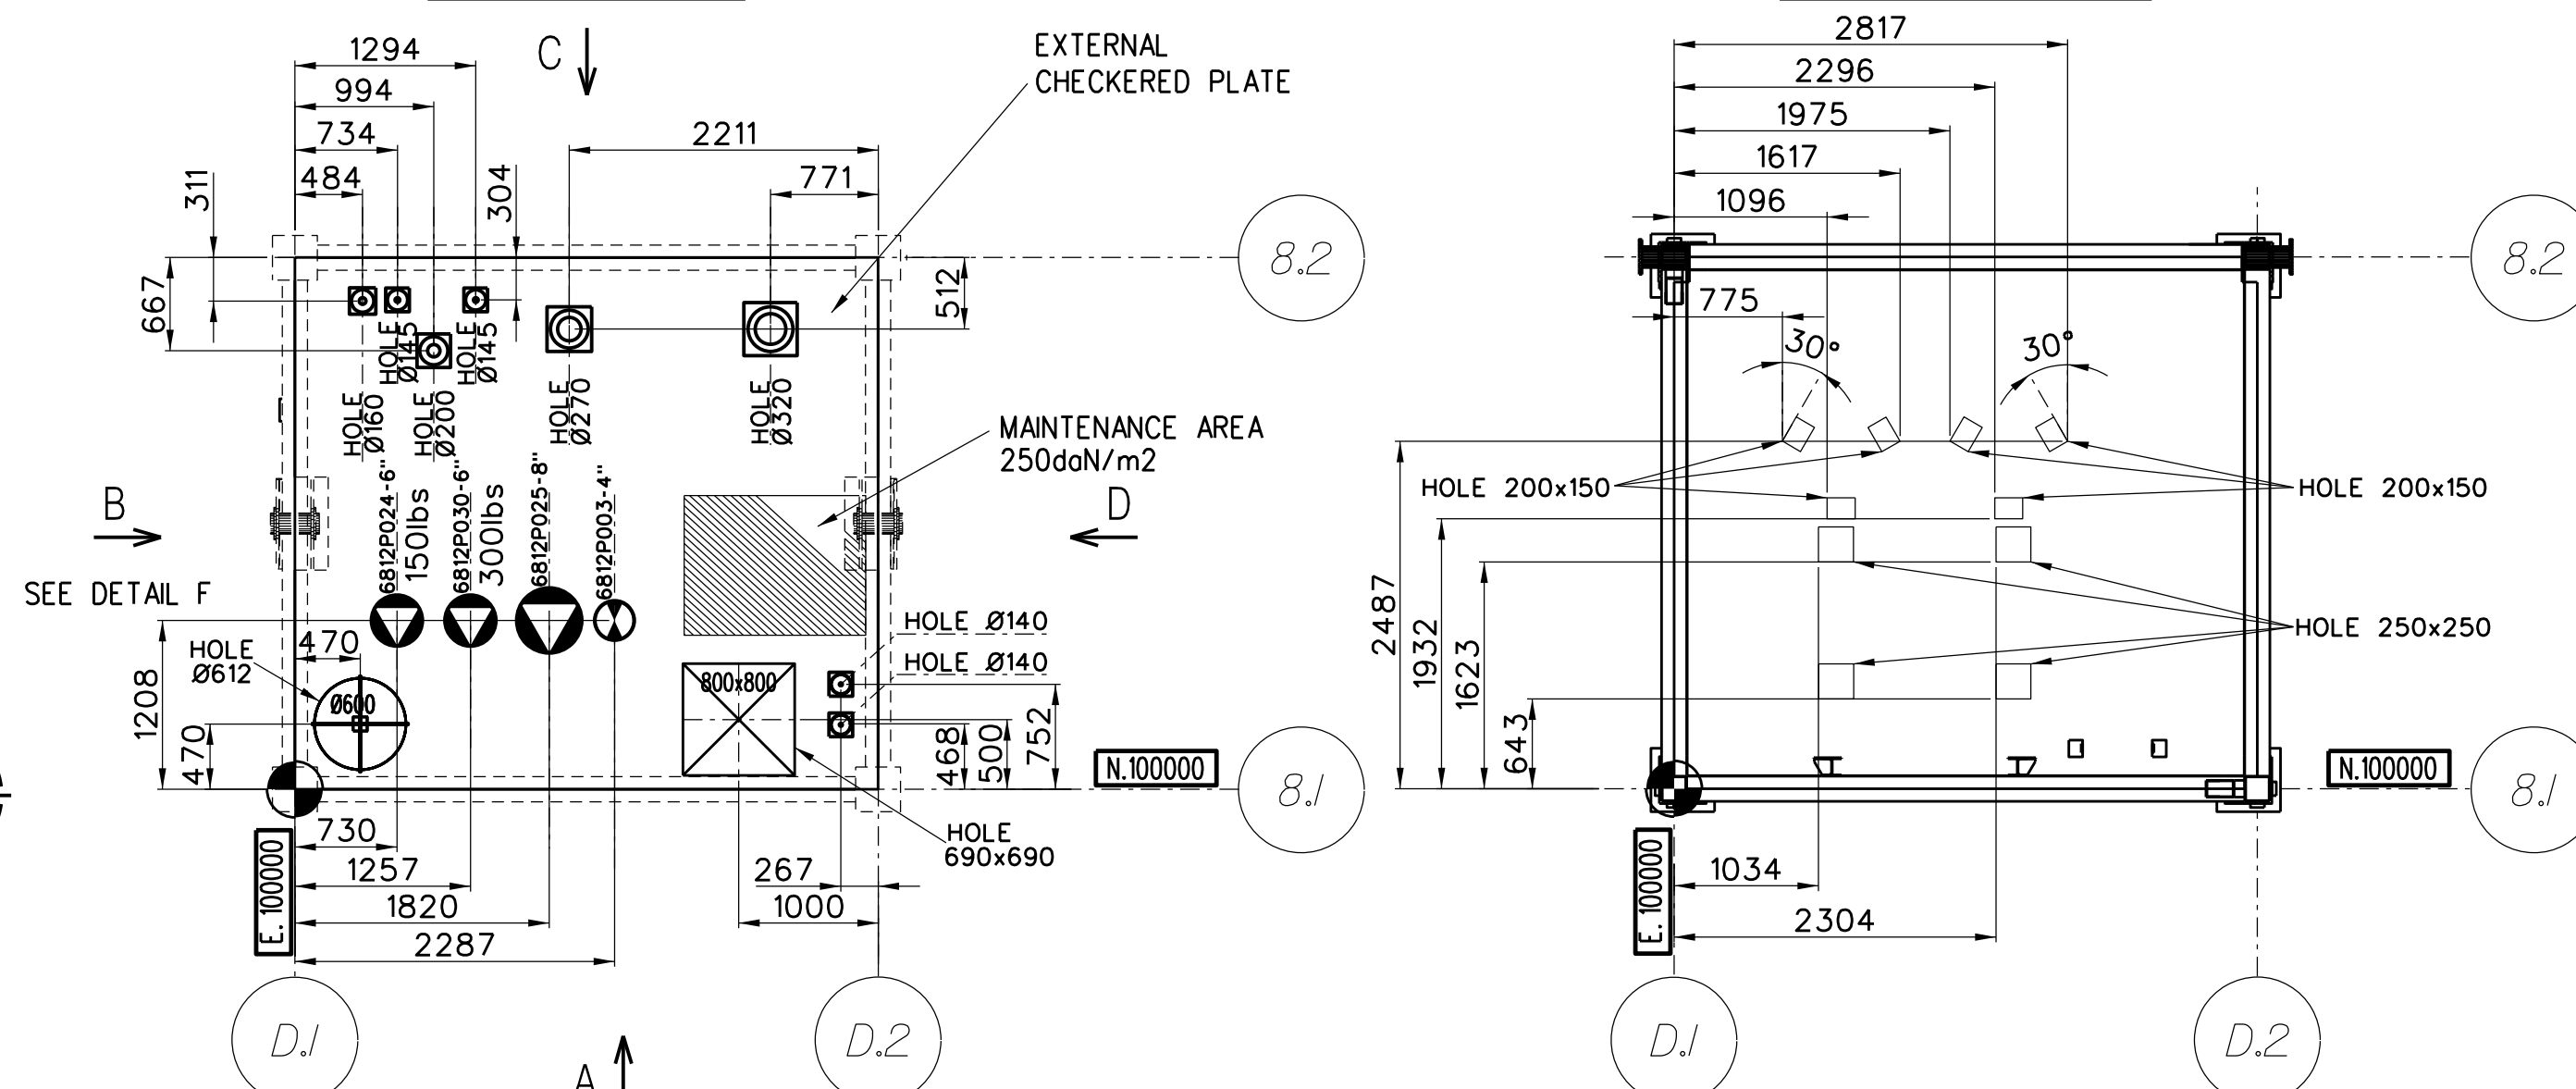

LEGEND

- ⊕ BLOW OFF AIR SEPARATION PLANT SEE G-DS-5-7-5
- ⊙ VALVE PASSTHROUGH SEE DETAIL T SEE DWG 53125-69-01-CS-212E011 2/2
- ⊙ VALVE PASSTHROW SEE DETAIL G DWG 53125-69-01-CS-212E011 2/2 SEE G-DS-5-3-2
- ⊙ VALVE PASSTHROW SEE DETAIL R DWG 53125-69-01-CS-212E011 2/2 SEE G-DS-5-3-2
- ⊙ PARTITION DUCT-FLEXIBLE VERTICAL ASSEMBLY SEE DWG 53125-69-01-CS-212E011 2/2 DETAIL F SEE G-DS-5-3-111
- ⊙ PARTITION DUCT-FLEXIBLE ASSEMBLY SEE DWG 53125-69-01-CS-212E011 2/2 DETAIL F SEE G-DS-5-3-111
- ⊙ INSPECTION DOORS SEE G-DS-2-1-1
- ⊙ PARTITION CROSSING DUCT PLATE SEE G-DS-5-3-131
- ⊙ MULTI PARTITION CROSSING DUCT PLATE SEE G-DS-5-3-133
- ⊙ JUNCTION BOX SEE E-DS-8-4-1

NOTES:

NOTE:

Cold box shall be airtight and waterproof. It is not allowed to weld supports on sheeting.








REFERENCES DRAWINGS:

53125-69-01-EM-017001
UNIT PLOT PLAN HELIUM RECOVERY FACILITIES (WIA)
3945_18-ME20829A-00281 / 53125-69-01-CS-214053
UPGRADER COLD BOX - GENERAL ARRANGEMENT ELEVATION VIEWS FOR UPGRADER AND EXPANDER/HELIUM LIQUEFIER/DISTRIBUTION SYSTEM
3945_18-ME20829A-00282 / 53125-69-01-CS-214054
UPGRADER COLD BOX - GENERAL ARRANGEMENT PLAN VIEWS FOR UPGRADER AND EXPANDER/HELIUM LIQUEFIER/DISTRIBUTION SYSTEM
3945_18-ME20829A-00761 / 53125-69-01-CS-21011.1/2
UPGRADER COLD BOX - ACCESSSES AND PLATFORM GUIDE DRAWING
3945_18-ME20829A-00761 / 53125-69-01-CS-21011.2/2
UPGRADER COLD BOX - ACCESSSES AND PLATFORM GUIDE DRAWING
3945_18-ME20829A-00284 / 53125-69-01-CS-214058
UPGRADER COLD BOX - PLAN VIEWS AND ELEVATION - SHEETING AND DETAIL FOR UPGRADER AND EXPANDER/HELIUM LIQUEFIER/DISTRIBUTION SYSTEM
3945_18-ME20829A-00762 / 53125-69-01-CS-212E011.2/2
UPGRADER COLD BOX - GENERAL SHEETING OPENING DRAWING

REFERENCE POINT:

⊙ ALE : E 100000 N 100000 EL 100000
SITE : E 12,127.705 N 10,414.940 EL +4400 QNH

DWG NO.		TITLE			
REFERENCE DRAWINGS					
50	FINAL (FNI)	RH	JM	JM	23-05-24
2	APPROVED FOR CONSTRUCTION (AFC)	RH	JM	TB	21-06-23
1	APPROVED FOR CONSTRUCTION (AFC)	RH	JM	MM	31-03-23
0	ISSUED FOR INFORMATION (IFI)	RH	JM	MM	24-01-23
NO.	DESCRIPTION	BY	CHKD	APVD	DATE
REVISIONS					
DATE	DRN	DSGND	CHKD	APVD	APVD
PROJECT TITLE :					
North Field East Project					
Onshore LNG Facilities					
G					
Qatargas Operating Company Ltd.					
THIS DOCUMENT IS PROPERTY OF QATARGAS. THIS DRAWING OR MATERIAL DESCRIBED THEREON MAY NOT BE COPIED OR REPRODUCED IN ANY FORM OR MEDIUM TO THIRD PARTIES OR USED FOR OTHER THAN THE PURPOSE FOR WHICH IT WAS BEING PROVIDED, IN WHOLE OR IN PART IN ANY MANNER EXCEPT AS EXPRESSLY PERMITTED BY QATARGAS.					
CONSULTANT / CONTRACTOR :					
CTJV					
Air Liquide					
ENGINEERING & CONSTRUCTION					
TITLE :					
UPGRADER COLD BOX -					
GENERAL SHEETING OPENING DRAWING					
H					
SCALE : 1/50		PROJECT NO. : LTC/C/NFE/3945/18			
PROJECT	DRAWING NO.		SHT	SIZE	REVISION
NFE1	3945_18-ME20829A-00762		1/2	A1	50
Ope.Center Doc No. 202038C-53125-69-01-CS-212E011					

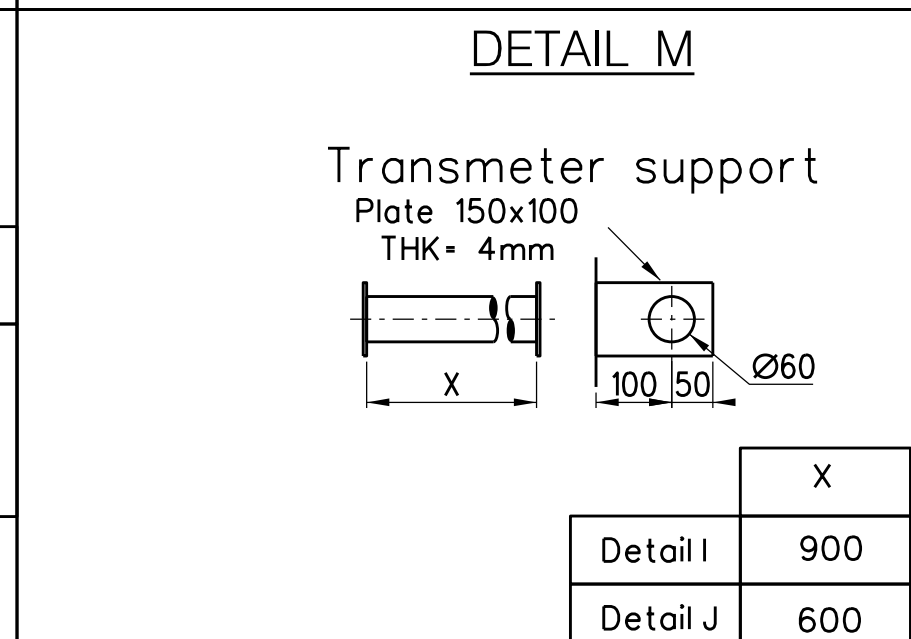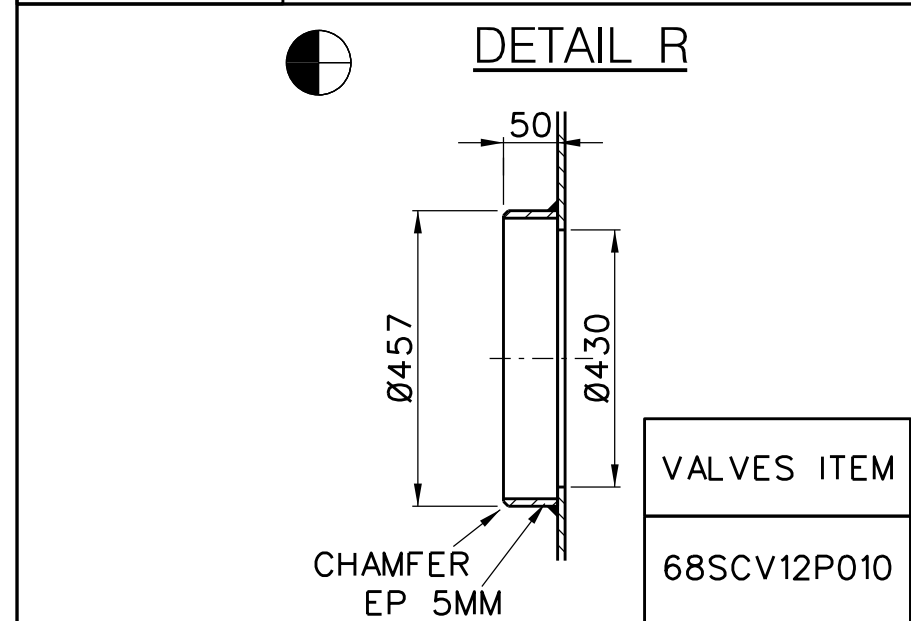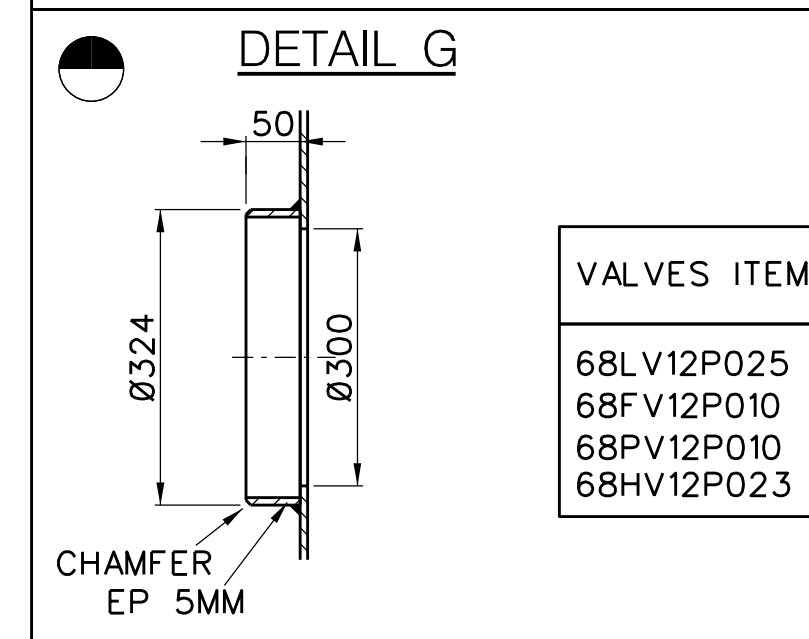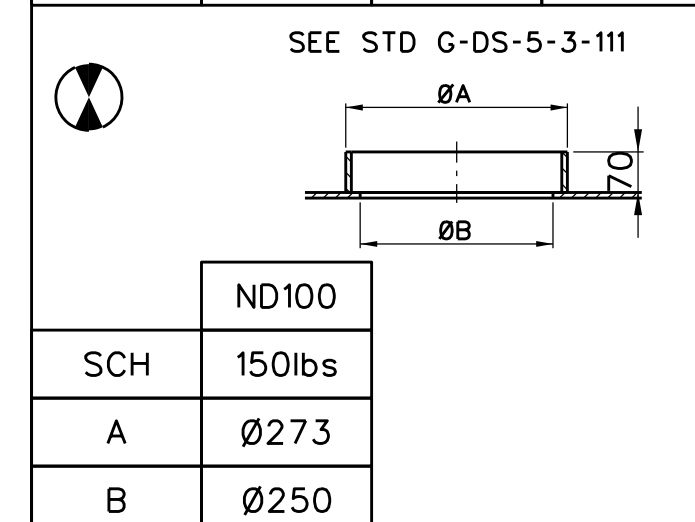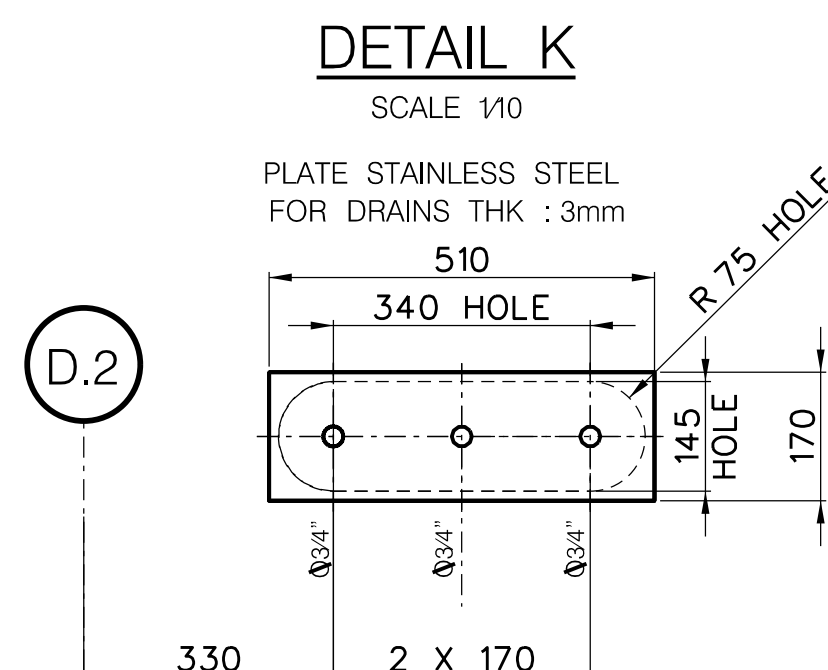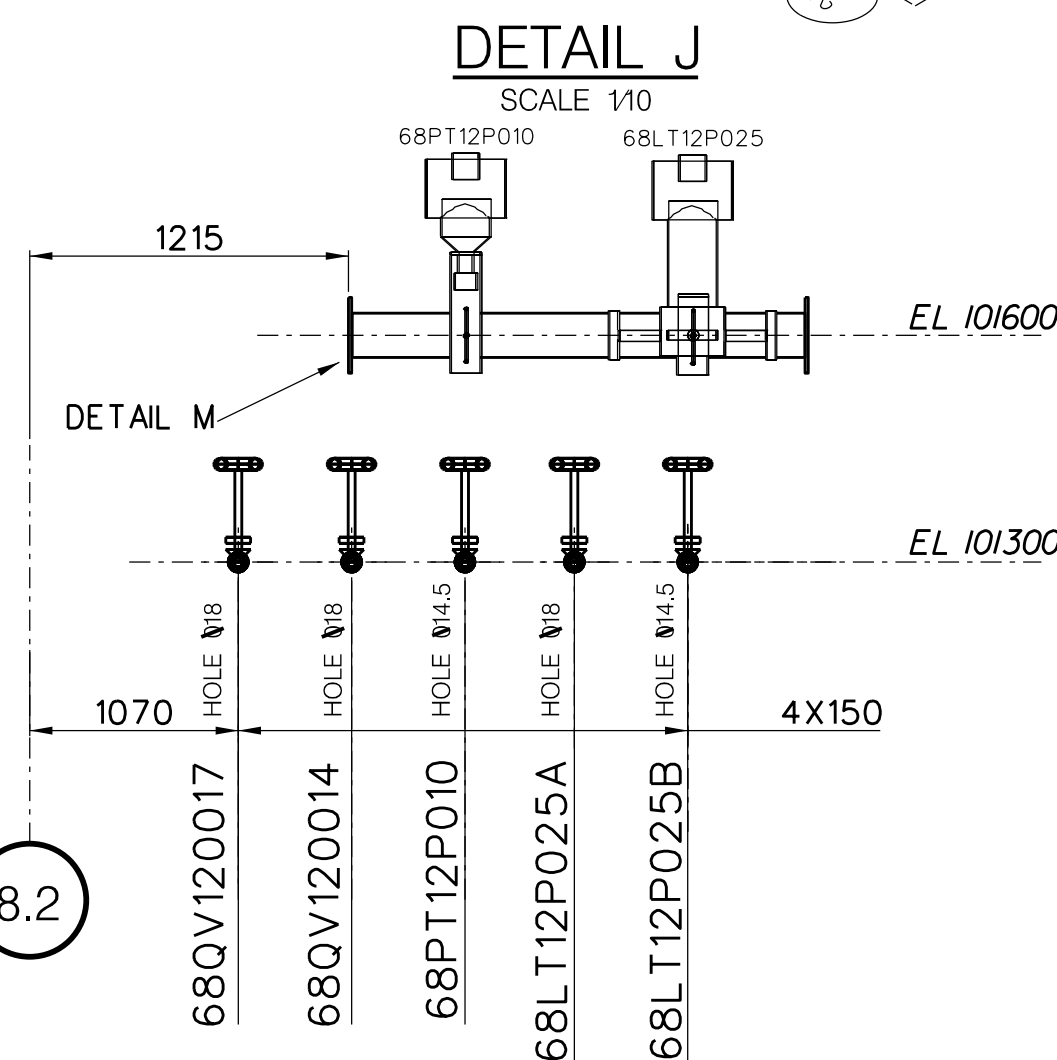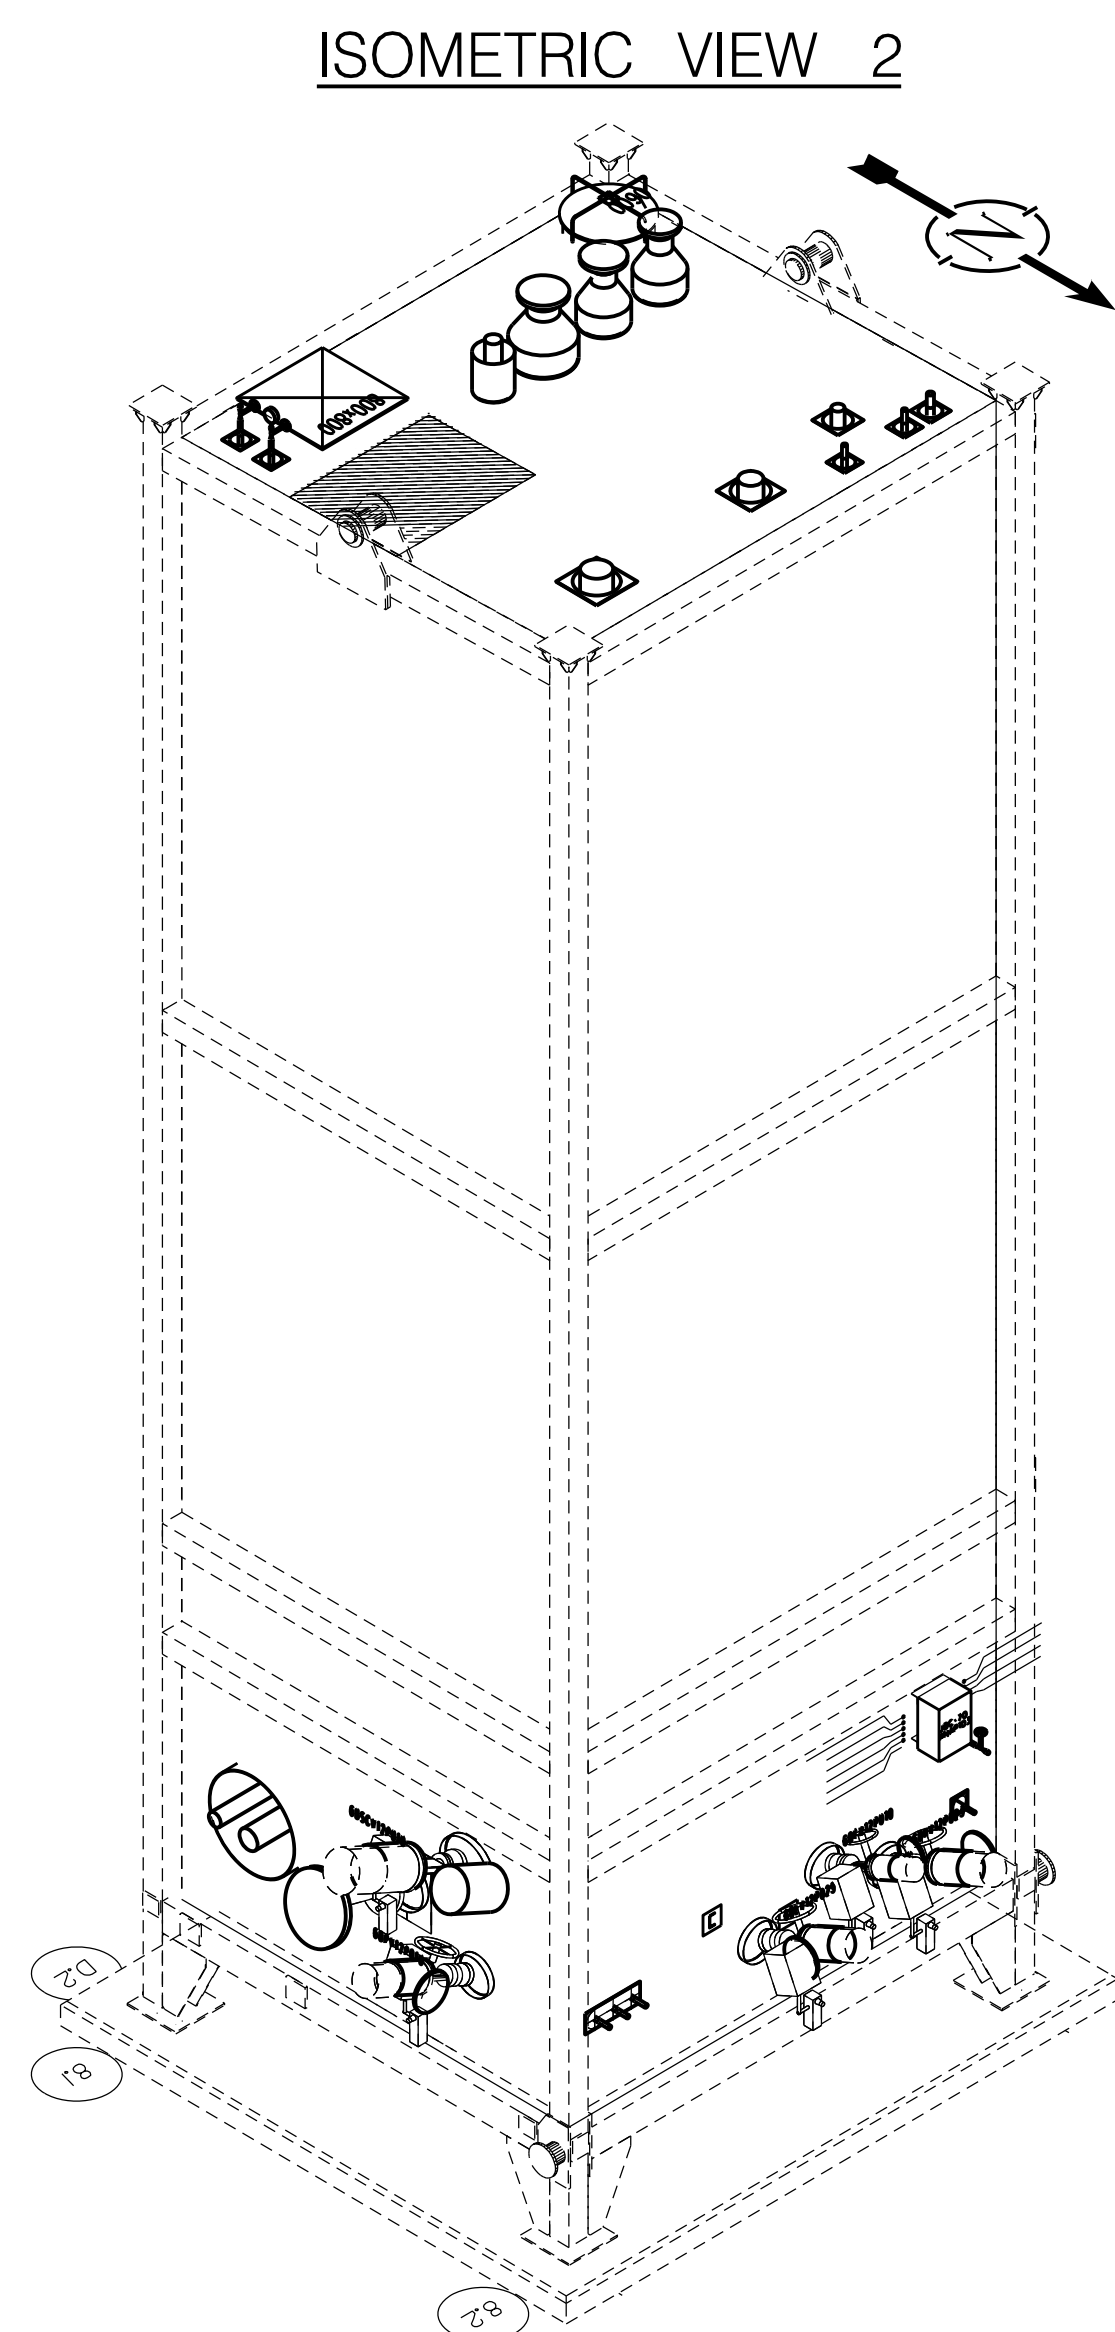

	ALE : E 100000	SITE : E 12,127.705
	N 100000	N 10,414.940
	EL 100000	EL +4400 QNH0

Op.Center Doc No.		202038C-53125-69-01-CS-212E011	
-------------------	--	--------------------------------	--

 JUNCTION BOX SEE E-DS-8-4-1

 EXPANDED METAL FOR CASING VALVES SEE G-DS-2-1-1